USS SARATOGA
AIRCRAFT CARRIER CV-60

COVER SHEET

THE DATE OF THIS ISSUE IS 16 JULY 2007

THIS IS A SELECTED RECORD DRAWING. THE REQUIREMENTS OF PARAGRAPH 8.b(1) OF NAVSEAINST 4720.12 APPLY WHICH STATE THAT ONE COPY OF THIS DRAWING IS TO BE DESIGNATED AS THE SHIP MASTER COPY. THIS COPY IS TO BE THE MASTER MARK-UP COPY AND TO EXTENT FEASIBLE SHOULD BE MAINTAINED CURRENT TO REFLECT ACTUAL SHIP CONFIGURATION FOR SHIPBOARD USE.

THIS DRAWING SHOWS COMPARTMENT FUNCTIONS REFLECTING ACTUAL SHIPBOARD CONFIGURATION. THIS DOES NOT IMPLY AUTHORITY FOR EXISTING COMPARTMENT USAGE. APPROVAL OF SUCH USAGE MUST BE PROVIDED BY SPECIFIC NAVSEA AUTHORITY AS PROVIDED BY OPNAVINST 4720.93.

DISTRIBUTION STATEMENT A: APPROVED FOR PUBLIC RELEASE; DISTRIBUTION IS UNLIMITED

	CORRECTED TO SUIT		
REV	PLACE	DATE	APPROVED
	NEW YORK NAVAL SHIPYARD	4/24/57	[illegible]
B	NORFOLK NAVAL SHIPYARD - CERTIFIED CORRECT BY CO. LTR CVA60/61 OF 12 MAY 1959	5-21-59	[illegible]
C	NEW YORK NAVAL SHIPYARD	5/31/61	[illegible]
	NORFOLK NAVAL SHIPYARD	1/8/63	[illegible]
	NORFOLK NAVAL SHIPYARD	9/22/64	[illegible]
	PHILADELPHIA NAVAL SHIPYARD	2/24/68	[illegible]
E	PHILADELPHIA NAVAL SHIPYARD	3/2/71	
F	PHILADELPHIA NAVAL SHIPYARD	6/28/72	[illegible]
G/H	NORFOLK NAVAL SHIPYARD	10-11-74	[illegible]
J	PORTSMOUTH NAVAL SHIPYARD, BOSTON PLANNING GROUP	11/1/75	[illegible]
K	NORFOLK NAVAL SHIPYARD	3/11/77	[illegible]
L	NORFOLK NAVAL SHIPYARD	5/10/78	[illegible]
M	NORFOLK NAVAL SHIPYARD	1/10/80	[illegible]
N	PHILADELPHIA NAVAL SHIPYARD	4/15/83	[illegible]
P	NORFOLK NAVAL SHIPYARD	4/4/85	[illegible]
R	NORFOLK NAVAL SHIPYARD	8/22/86	[illegible]
S	NORFOLK NAVAL SHIPYARD		
T	NORFOLK NAVAL SHIPYARD	8/2/91	[illegible]
U	NORFOLK NAVAL SHIPYARD	9-3-93	[illegible]
Z	NAVSEA / NSWC CARDEROCK DIVISION	7-16-2007	

ORDER OF PLANS

TITLE	SHEET NO.	PLATE NO.
COVER SHEET	1	1
GENERAL INFORMATION DATA	1	2
OUTBOARD PROFILE-STBD	2	3
OUTBOARD PROFILE-PORT	3	4
INBOARD PROFILE	7	5
ISLAND LEVELS & BRIDGES	3	6
FLIGHT DECK	4	7
GALLERY DECK	5	8
02 LEVEL	6	9
01 LEVEL	7	10
MAIN DECK	8	11
SECOND DECK	8	12
THIRD DECK	9	13
FOURTH DECK	9	14
FIRST PLATFORM	10	15
SECOND PLATFORM	10	16
HOLD	11	17
DOUBLE BOTTOM	11	18

REDACTED
BOOKLET
OF
GENERAL PLANS

SELECTED RECORD DRAWING

PREPARED BY

M. ROSENBLATT & SON 253 BROADWAY, N.Y.N.Y.

FOR NEW YORK NAVAL SHIPYARD, BROOKLYN, N.Y.

SERIAL NO.

GENERAL DIMENSIONS

HULL

LENGTH BETWEEN PERPENDICULARS, FR. 0 – FR. 247 ½	990'-0"
PROJECTION FORWARD OF FORWARD PERPENDICULAR	26'-0"
PROJECTION AFT OF AFTER PERPENDICULAR	18'-0"
LENGTH, OVERALL	1034'-0"
BREADTH, EXTREME (OVER WALKWAYS)	88'-8 3/16"
DRAFT, ABOVE BOTTOM OF KEEL – (DESIGNER'S WATERLINE)	35'-9 3/16"
FRAME SPACING	4'-0"

HEIGHTS OF MASTS, LIGHTS, & PLATFORMS

	(DESIGNER'S DRAFT 35'-9" ABL)
TOP OF MAINMAST, OVERALL CLEARANCE	205'-6") ABL
MAINMAST "HINGE POINT"	64'-5") 35'-9"
HEIGHTS OF PLATFORMS AND LEVELS ABOVE FLIGHT DK	SEE PLATE NO. 6 (SHEET 3)

* CENTER LINE OF LIGHTS ABOVE 35'-9" DRAFT

F SIDE LIGHT (RED) FRAME NO. 128'-6" TO PORT OF SHIP CL, 17'-4" BELOW FLIGHT DK LEVEL	61'-11"
F SIDE LIGHT (GREEN) FRAME NO. 135'-0" TO STBD OF SHIP CL, 17'-2" BELOW FLIGHT DK LEVEL	62'-1"
A STERN LIGHT (CLEAR) FR. 248 2'-0" TO STBD OF SHIP CL	35'-5"
A STERN LIGHT (BLUE) FR. 248 6'-0" TO SHIP	33'-8"
FWD MASTHEAD LIGHT (ON FIXED POLEMAST) 184'-6" TO STBD OF SHIP CL FR. 69	103'-10"
AFT MASTHEAD LIGHT (ON MAIN MAST) 184'-6" TO STBD OF SHIP CL, FR. 118	151'-1"
FWD ANCHOR LT. FR. 241 (+) TO PORT OF SHIP CL	165'-4"
AFT ANCHOR LT. FR. 245 ON SHIP CL	151'-8"
BLINKER LIGHTS (CLEAR) ON TIPS OF SIGNAL YARDARM ON MAINMAST	142'-1"
NAVY BEACON LIGHTS ON TIPS OF SIGNAL YARDARM ON MAINMAST	142'-1"
SIGNAL & HOMING LIGHTS, 2'-0" FWD. FR. 138 BELOW O.I.O. LEVEL	111'-6"
WAKE LIGHT (CLEAR) 6' SHIP ON SHELL, FR. 218	26'-10"
* MAN OVERBOARD, BREAKDOWN & DRAFT, & TASK LIGHTS: (ON BOLTED STUBMAST)	
UPPER (RED) FR. 123	196'-5"
MIDDLE (WHITE/RED) FR. 123	181'-1"
LOWER (RED) FR. 123	165'-9"
HORIZONTAL DISTANCE OF FWD MASTHEAD LT TO AFT MASTHEAD LT	212'-0"
STEM TO FWD MASTHEAD LT	240'-0"
FWD MASTHEAD LT TO SIDE LT (PORT) AFT	6'-1"
FWD MASTHEAD LT TO SIDE LT (STBD) AFT	97'-9 1/2"

* HEIGHTS ARE IN ACCORDANCE WITH NNSY NAVIGATIONAL LIGHT CERTIFICATION MEMO SPEC 270-1-2428 DATED 12 MAR 85

LIST OF SMALL BOATS

TYPE	NO.	CAPACITY	TOTAL
50 FT. UTILITY BOAT	5	150	750
# 40 FT. PERSONNEL BOAT, MARK 2	4	43	172
26 FT. MOTOR WHALE BOAT, MARK 2	2	22	44
14 FT. PUNT	3	75	225
40 FT. MOTOR LAUNCH			
ENCAPSULATED LIFERAFTS	104	25 MEN	5100

INCLUDES ONE ADMIRAL BARGE (TRANSIENT) WITH CRADLE

CAPACITY OF BOOMS & CRANES

BOAT AND AIRCRAFT CRANE	50,000 LBS
RIGGED WITH SINGLE WHIP HOIST	5,000 LBS
RIGGED FOR TWO-PART PURCHASE	10,000 LBS

ACCOMMODATIONS

PERSONNEL	BERTHS	BEDS	LOCKERS (TYPE) A	LOCKERS (TYPE) D	BERTHS
FLAG OFFICERS		5			
SHIP'S OFFICERS	428				436
C.P.O.	268		255	26	270
CREW	4155				4177
MARINES	62				66
1ST SGT MARINES	1		1		1
SICK BAY WARDS	34	34			34
SEA CABINS	5				5

ABBREVIATION:

FZ	FIRE ZONE, (BULKHEADS/DECK BOUNDARY)
FOO	FUEL OIL OVERFLOW
CD	COFFERDAM
B	BALLAST

DATA SHEET

CV-60- PLATE 2

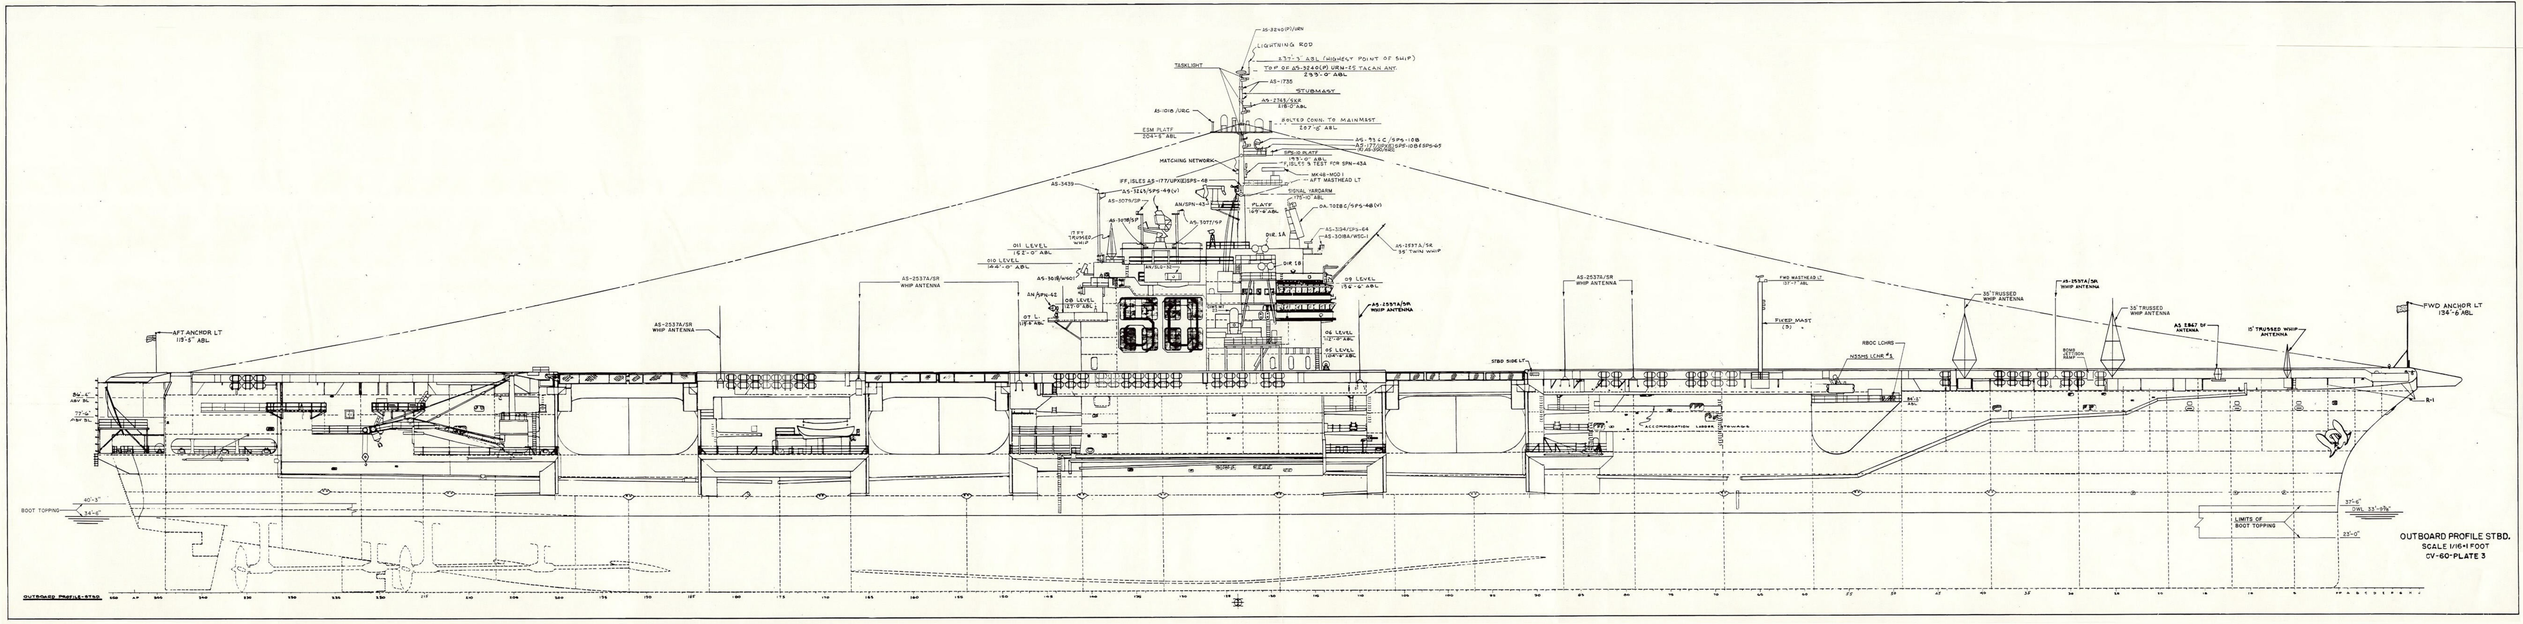
AS-3240(P)/URN
LIGHTNING ROD
TASKLIGHT
137'-3" ABL (HIGHEST POINT OF SHIP)
TOP OF AS-3240(P) URN-25 TACAN ANT.
239'-0" ABL
AS-1736
"STUDMAST"
AS-2765/SRR
118'-0" ABL
AS-1018 /URC
BOLTED CONN. TO MAINMAST
207'-0" ABL
ESM PLATF.
204'-8" ABL
AS-73 LC /SPS-10B
AS-1772/SPS-10B&SPS-65
AS-1772/SPS-10B
SPS-8 PLATF.
193'-0" ABL
MATCHING NETWORK
BOLTS & TEST FOR SPN-43A
MK48-WDC1
AFT MASTHEAD LT
AS-3439
FF, ISLES AS-1737/UPX2/SPS-6B
AS-3265/SPS-49(V)
AS-3075/SP
AN/SPN-43
SIGNAL YARDARM.
175'-0" ABL
PLATF.
169'-8" ABL
OA-10086/SPS-48(V)
AS-3077/SP
DIE 1A
AS-3341/SPS-64
AS-3088A/WSC-1
AS-1937A/SR
35' TWIN WHIP
DIE 1B
011 LEVEL
162'-0" ABL
010 LEVEL
144'-0" ABL
AS-3068/WSC-1
AN/SPN-42
OB LEVEL
121'-9" ABL
OT L
119'-8" ABL
AS-2537A/SR
WHIP ANTENNA
AS-2537A/SR
WHIP ANTENNA
AS-2537A/SR
WHIP ANTENNA
AS-2537A/SR
WHIP ANTENNA
AS-2537A/SR
WHIP ANTENNA
AFT ANCHOR LT
115'-5" ABL
FWD MASTHEAD LT
137'-7" ABL
FIXED MAST
(3)
35' TRUSSED
WHIP ANTENNA
35' TRUSSED
WHIP ANTENNA
AS 2867 Df
ANTENNA
15' TRUSSED WHIP
ANTENNA
FWD ANCHOR LT
134'-6" ABL
RBOC LCHRS
NSSHG LCHR #3
STBD SIDE LT
ACCOMMODATION LADDER STOWAGE
BOOT TOPPING
LIMITS OF
BOOT TOPPING
OUTBOARD PROFILE STBD.
SCALE 1/16=1 FOOT
CV-60-PLATE 3

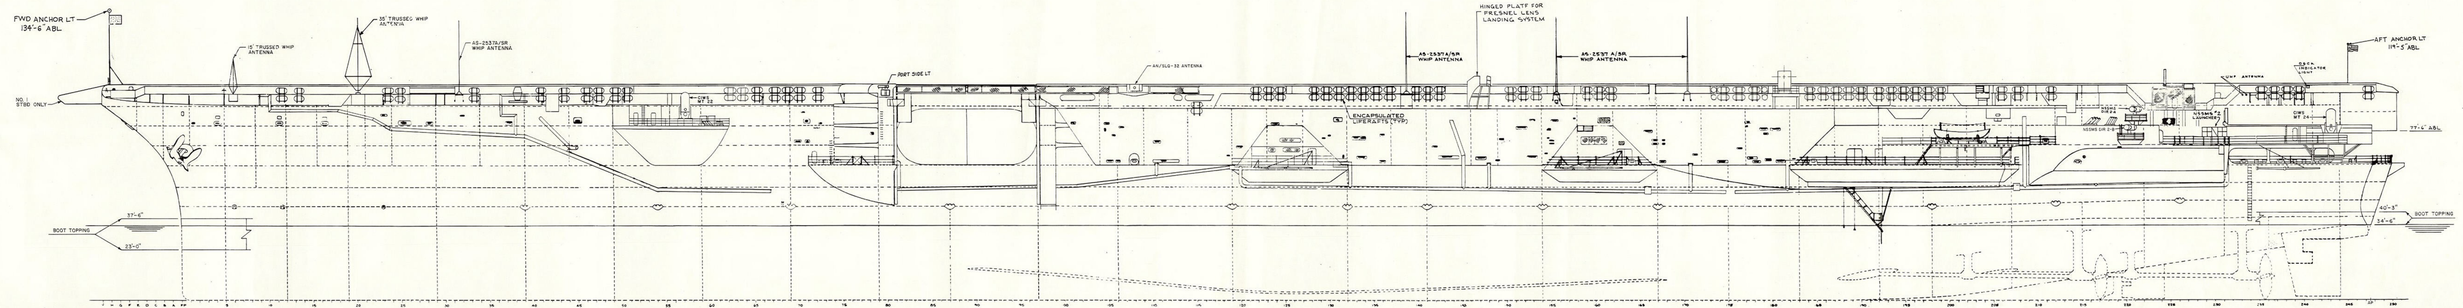

OUTBOARD PROFILE - PORT

OUTBOARD PROFILE - PORT
SCALE: 1/16" = 1'-0"
PLATE 4

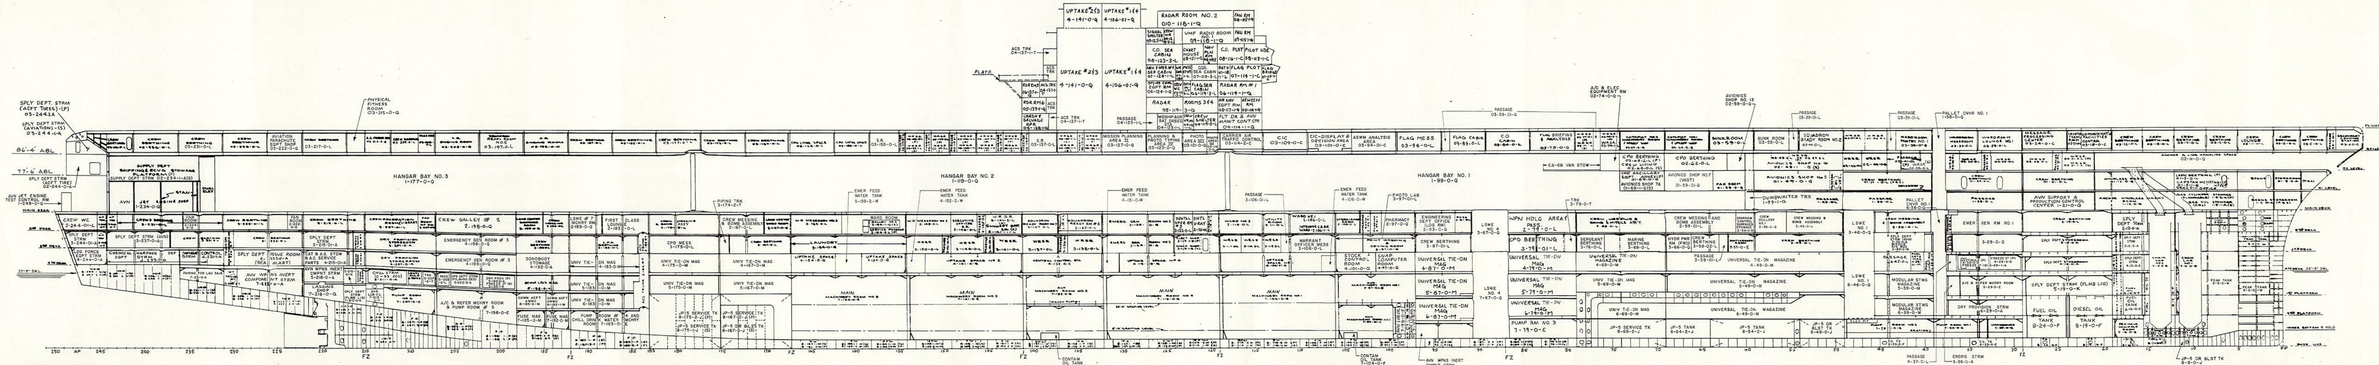

INBOARD PROFILE
SCALE: 1/16" = 1'-0"
CV-60-PLATE 5

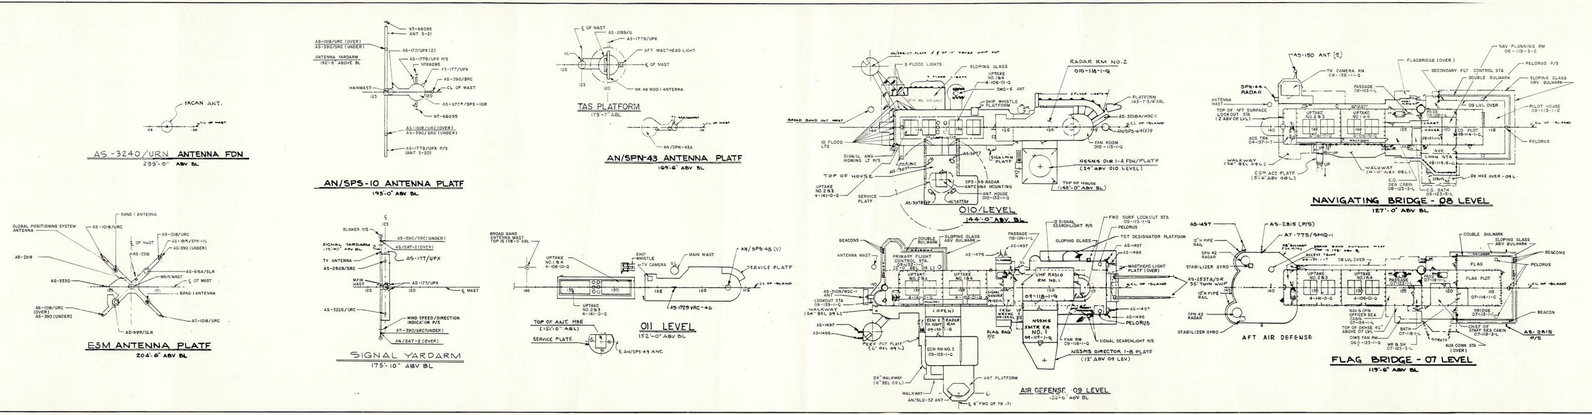
AS-3240/URN ANTENNA FDN
255'-0" ABV BL
AN/SPS-10 ANTENNA PLATF
193'-0" ABV BL
TAS PLATFORM
AN/SPN-43 ANTENNA PLATF
169'-6" ABV BL
E3M ANTENNA PLATF
204'-6" ABV BL
SIGNAL YARDARM
175'-10" ABV BL
011 LEVEL
(12'-0" ABV BL)
O10/O9 LEVEL
(44'-0" ABV BL)
AIR DEFENSE 09 LEVEL
(32'-0" ABV BL)
NAVIGATING BRIDGE - 08 LEVEL
(127'-0" ABV BL)
FLAG BRIDGE - 07 LEVEL
(119'-6" ABV BL)
AFT AIR DEFENSE
06 LEVEL
(92'-0" ABV BL)
05 LEVEL
(104'-6" ABV BL)
ISLAND LEVELS
SCALE: 1/16"=1'-0"
CV-60-PLATE 6

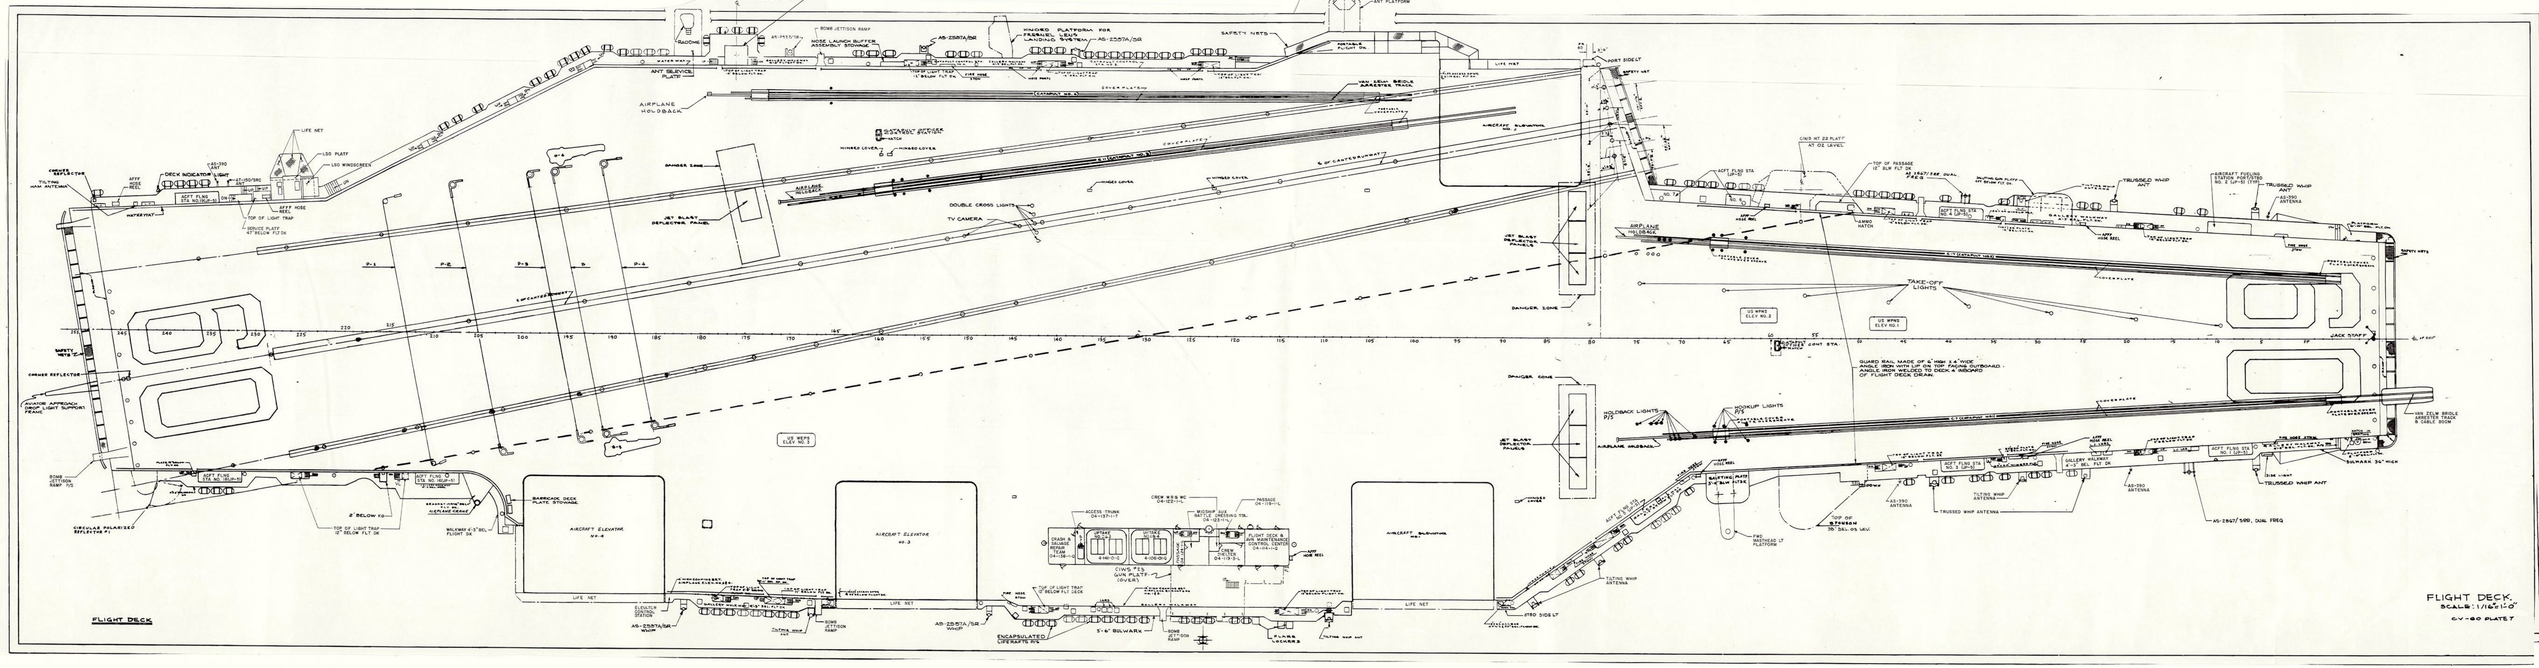
FLIGHT DECK
SCALE: 1/16"=1'0"
CV-60 PLATE 7
FLIGHT DECK
RADOME
DEARM PLATFORM
BOMB JETTISON RAMP
NOSE LAUNCH BUTTER ASSEMBLY STATION
AS-2587A/SR
HINGED PLATFORM FOR FASNIPS USE
AS-2587A/SR
SAFETY NETS
AN/SLQ-32 ANT
ANT PLATFORM
ANT SERVICE PLATF
WATER MAIN
AIRPLANE HOLDBACK
LIFE NET
LSO PLATF
LSO WINDSCREEN
DECK INDICATOR LIGHT
TILTING JAM ANTENNA
AS-390 ANTENNA
AFFF HOSE REEL
AFFF FLDG STA NO. 4 SELF DEL
TOP OF LIGHT TRAP
SPRUCE PLATF 47' BELOW FLT DK
HINGED COVER
DANGER ZONE
JET BLAST DEFLECTOR PANEL
DOUBLE CROSS LIGHTS
TV CAMERA
ENCAPSULATED
CONVEX REFLECTOR
FRESNEL APPROACH DROP LIGHT SUPPORT FRAME
BOMB JETTISON RAMP
CIRCULAR POLARIZED REFLECTOR
2' BELOW FD
TOP OF LIGHT TRAP 12' BELOW FLT DK
BULWARK 4'-5" BEL FLIGHT DK
BARRICADE DECK PLATE STOWAGE
AIRCRAFT ELEVATOR NO. 4
AIRCRAFT ELEVATOR NO. 3
AIRCRAFT ELEVATOR NO. 2
ACCESS TRUNK
CREW MESS MC
MICROWAVE RELAY
PASSAGE
FLIGHT DECK & AIR MAINTENANCE CONTROL CENTER
CIWS #3 GUN PLATF (OVER)
ENCAPSULATED DIPEAPTR WK
3'-6" BULWARK
FLAME LOCKER
FWD SIDE LT
AFT SIDE LT
PORT SIDE LT
AIRPLANE HOLDBACK
AIRPLANE HOLDBACK
HOLDBACK LIGHTS
HOOKUP LIGHTS
WAITING PLATF 3'-6" BLW FLT DK
FWD WAITING LT PLATFORM
TOP OF STARBOARD 35" BAL-95 UEV.
TILTING WHIP ANTENNA
TRUSSED WHIP ANTENNA
TRUSSED WHIP ANT
AS-2867/SRD, DUAL FREQ
BULWARK 36" HIGH
TAKE-OFF LIGHTS
GUARD RAIL MADE OF 6" HIGH 3.4" WIDE ANGLE IRON WITH LIP ON TOP FACING OUTBOARD. ANGLE IRON WELDED TO DECK & INBOARD OF FLIGHT DECK DRAIN.
JACK STAFF
VAN ZEULR BRIDLE ARRESTER TRUNK & CABLE BOOM

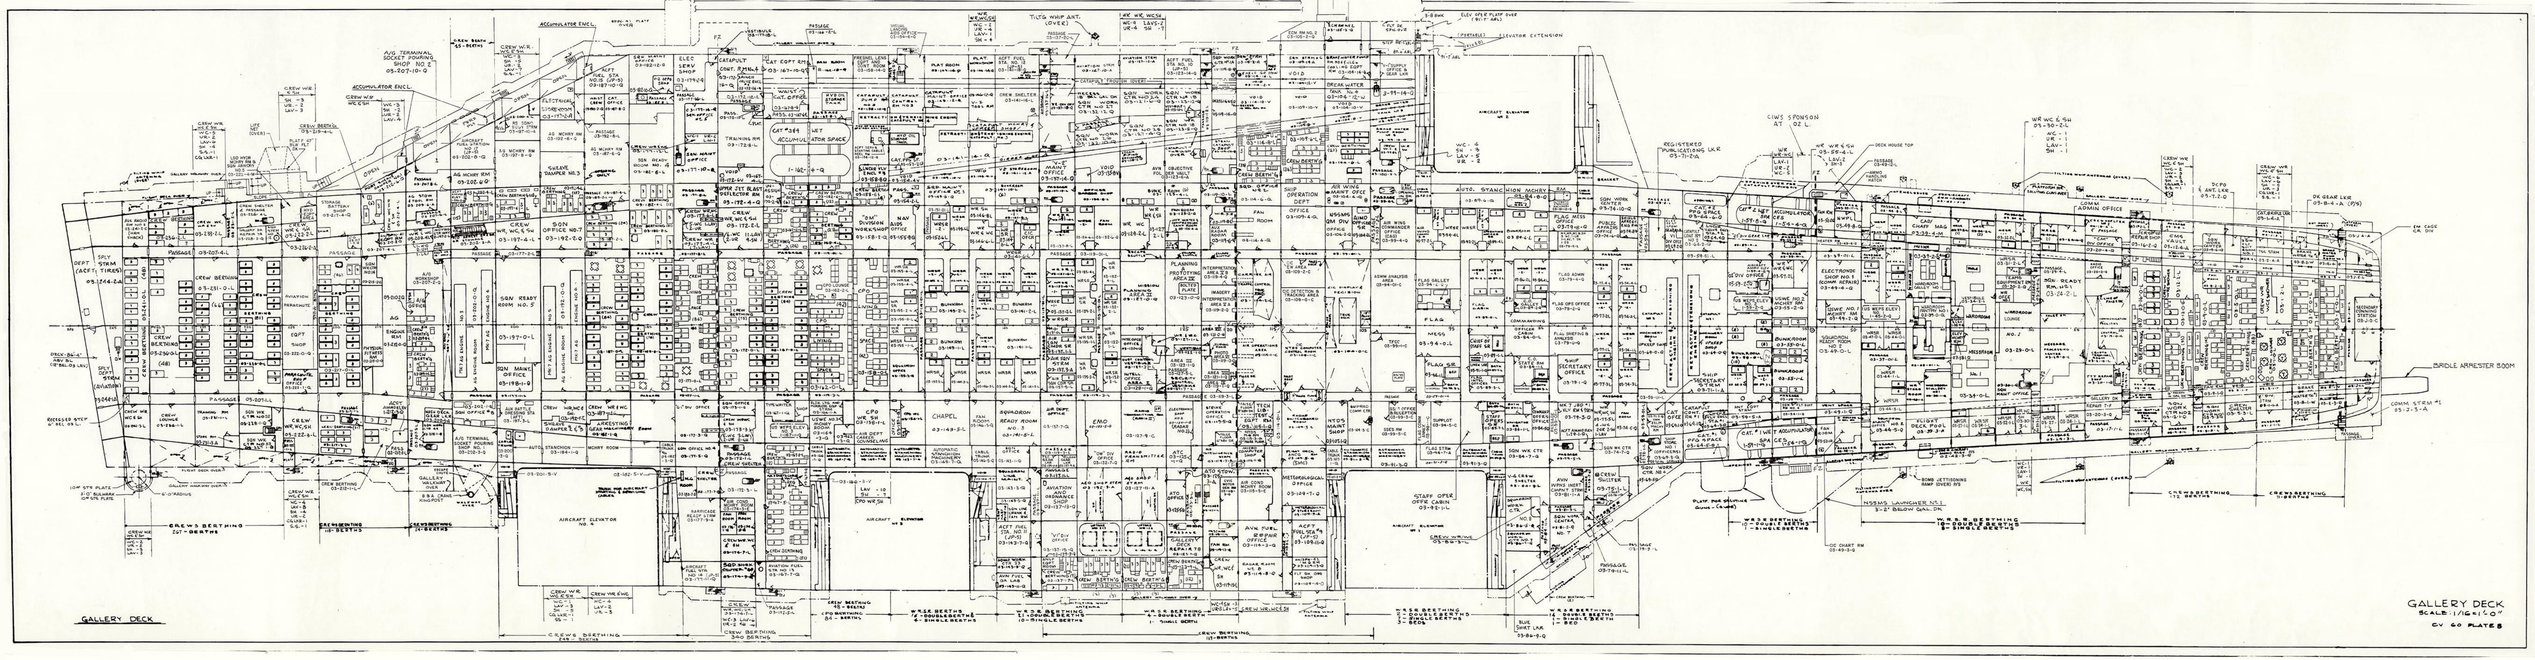
GALLERY DECK
SCALE: 1/16" = 1'-0"
CV 60 PLATES
CREW'S BERTHING
CATAPULT
AIRCRAFT ELEVATOR NO. 4
AIRCRAFT ELEVATOR NO. 3
CHAPEL
AUTO. STANCHION MAGAZINE
STAFF OFFR OFFR CABIN
COMM ADMIN OFFICE
BRIDLE ARRESTER BOOM

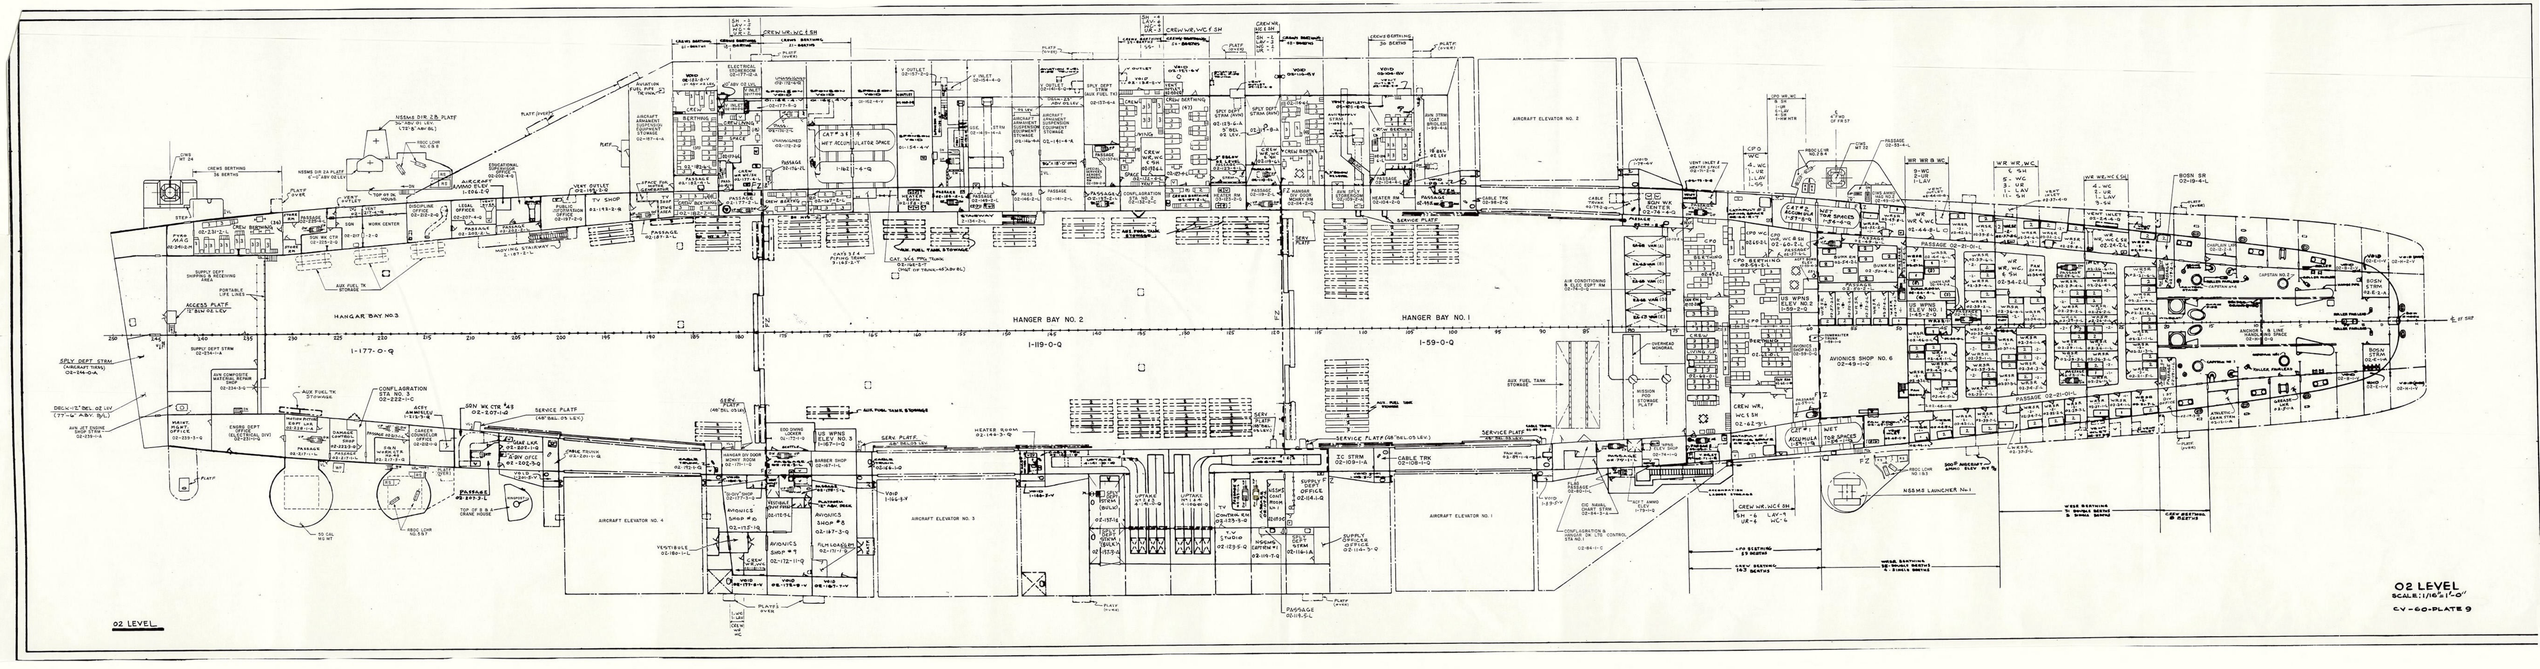
02 LEVEL
SCALE: 1/16"=1'-0"
CV-60-PLATE 9
HANGAR BAY NO. 3
HANGER BAY NO. 2
HANGER BAY NO. 1
AIRCRAFT ELEVATOR NO. 4
AIRCRAFT ELEVATOR NO. 3
AIRCRAFT ELEVATOR NO. 2
AIRCRAFT ELEVATOR NO. 1
CATAPULT 3 & 4
AVIONICS SHOP NO. 6
NSSMS LAUNCHER No. 1
CREW WR, WC & SH
CREW WR, WC & SH
CREW WR, WC & SH

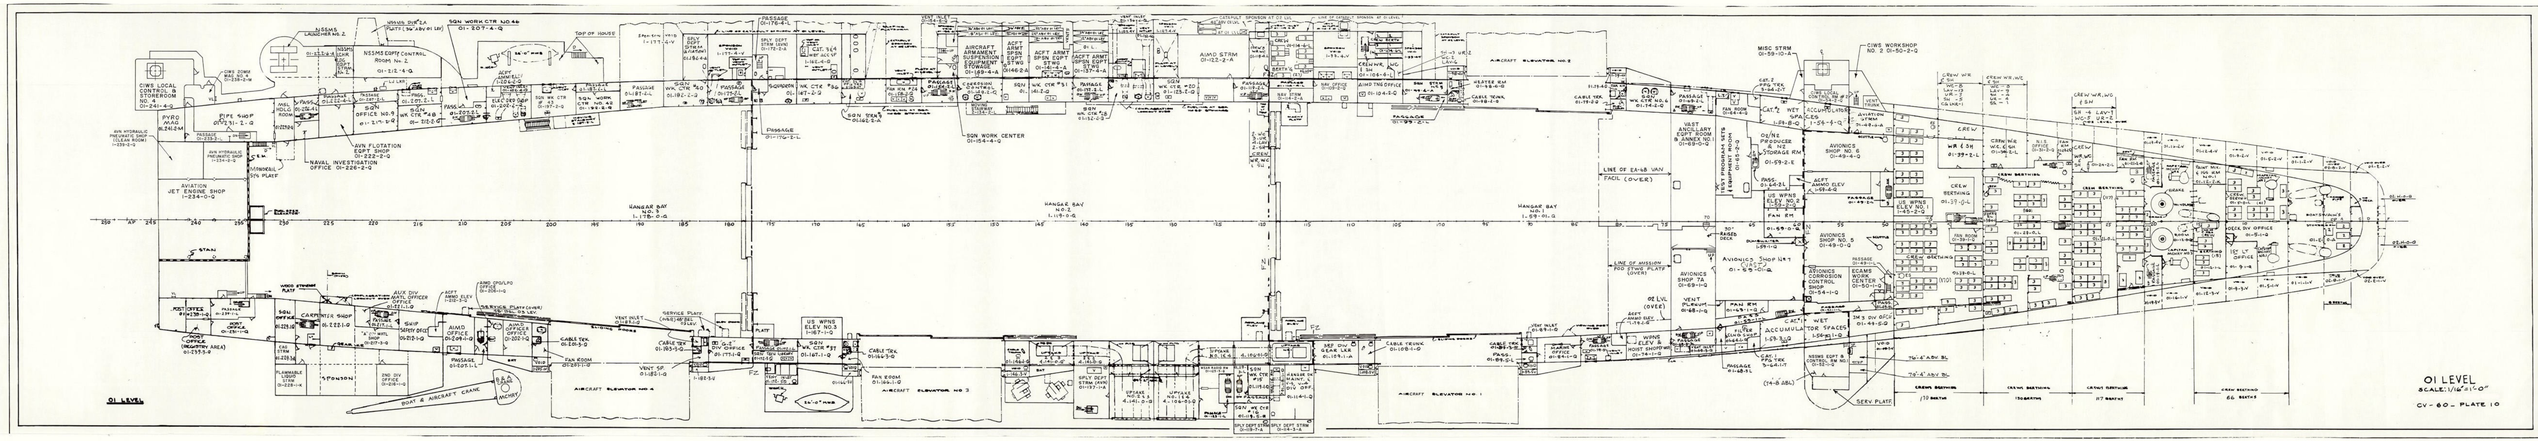
01 LEVEL
SCALE: 1/16" = 1'-0"
CV-60 - PLATE 10
HANGAR BAY NO. 1
HANGAR BAY NO. 2
HANGAR BAY NO. 3
AIRCRAFT ELEVATOR NO. 1
AIRCRAFT ELEVATOR NO. 2
AIRCRAFT ELEVATOR NO. 3
AIRCRAFT ELEVATOR NO. 4
CREW BERTHING
CREW LOUNGE
CREW LAVATORY
CREW WR & SH
CREW MESS
CREW WR, WC

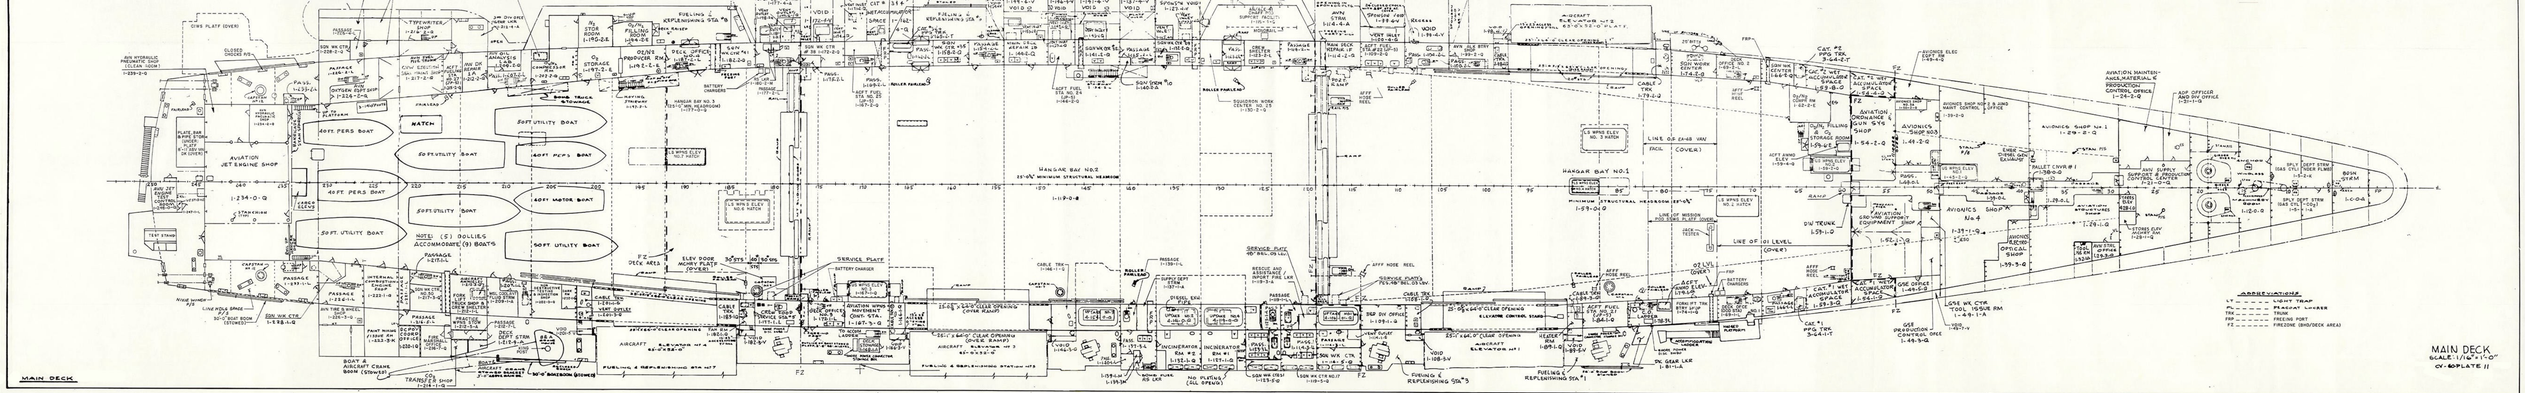
MAIN DECK
SCALE: 1/16" = 1'-0"
CV-60 PLATE 11
HANGAR BAY NO. 2
HANGAR BAY NO. 1
AVIATION JET ENGINE SHOP
AVIONICS SHOP
AVIATION ORDNANCE & GUN SYS SHOP
AVIONICS SHOP (UH-1)
AVIONICS SHOP
AVIONICS SHOP
OPTICAL SHOP
AVIATION GROUND EQUIPMENT SHOP
AVIATION MAINTENANCE, MATERIAL & PRODUCTION CONTROL OFFICE
ADP OFFICER AND DIV. OFFICE
DIV. SUPPLY CONTROL & PROCUREMENT CONTROL SUPERVISOR
DIV. TRUNK
LINE OF MISSILE HOIST PLATE COVERS
LINE OF 01 LEVEL
LINE OF 02 LEVEL
LINE OF

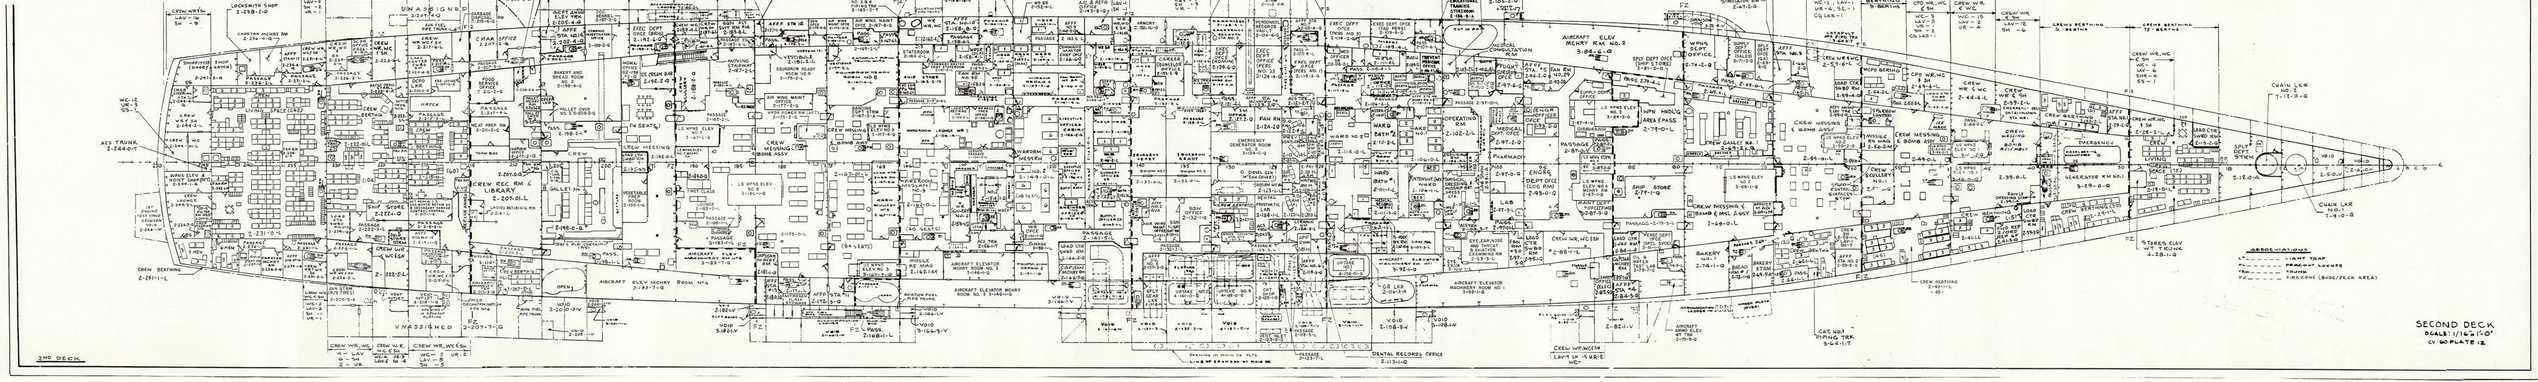
SECOND DECK
SCALE: 1/16"=1'-0"
2ND DECK
UNASSIGNED
CREW REC RM & LIBRARY
CREW MESSING
CREW BERTHING
EMERGENCY
ACE TRUNK
CHAIN LKR NO. 1
CHAIN LKR NO. 2
DENTAL RECORDS OFFICE
AIRCRAFT ELEV MCHRY RM NO. 2
AIRCRAFT ELEVATOR MOTOR ROOM NO. 1
AIRCRAFT ELEVATOR MOTOR ROOM NO. 2
AIRCRAFT ELEV MCHRY ROOM NO. 1
BAKERY
SHIP STORE
MEDICAL DEPT OFFICE
DENTAL DEPT OFFICE
ABBREVIATIONS
LT. LIGHT TRAP
F.D. FIREDOOR LOUVRE
TR. TRUNK
FZ. FIREZONE (BHDS/DECK AREA)

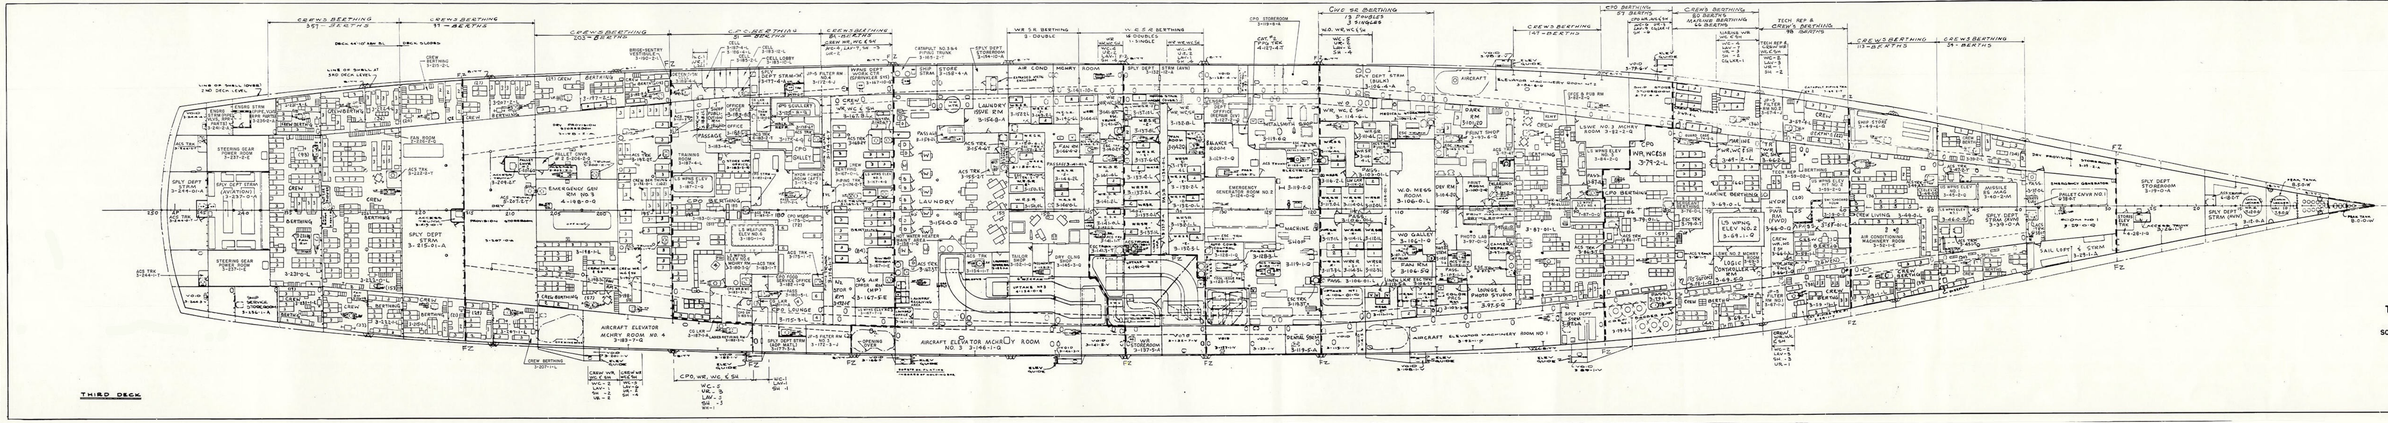
THIRD DECK
PLATE D
SCALE = 1/16" = 1'-0"
THIRD DECK
CREW'S BERTHING 35T - BERTHS
CREW'S BERTHING 31 - BERTHS
CREW'S BERTHING 20T - BERTHS
CREW'S BERTHING 17 - BERTHS
CREW'S BERTHING 5 - SINGLES
W.R.S. BERTHING 3 - DOUBLE
W.R.S. BERTHING 1 - SINGLE
CREW'S BERTHING 13 - DOUBLES 3 - SINGLES
CREW'S BERTHING 47 - BERTHS
CREW'S BERTHING 25 - BERTHS
CREW'S BERTHING 13 - BERTHS
CREW'S BERTHING 29 - BERTHS
AIRCRAFT ELEVATOR MACHINERY ROOM NO. 4
AIRCRAFT ELEVATOR MACHINERY ROOM NO. 3
AIRCRAFT ELEVATOR MACHINERY ROOM NO. 1
AIRCRAFT
SPLY DEPT STORE ROOM
SPLY DEPT STORE ROOM 3-19-1-A
SPLY DEPT STRM (AVIATION) 3-21-1-A
SPLY DEPT STRM 3-21-6-1-A
SPLY DEPT STRM (WW) 3-19-1-A

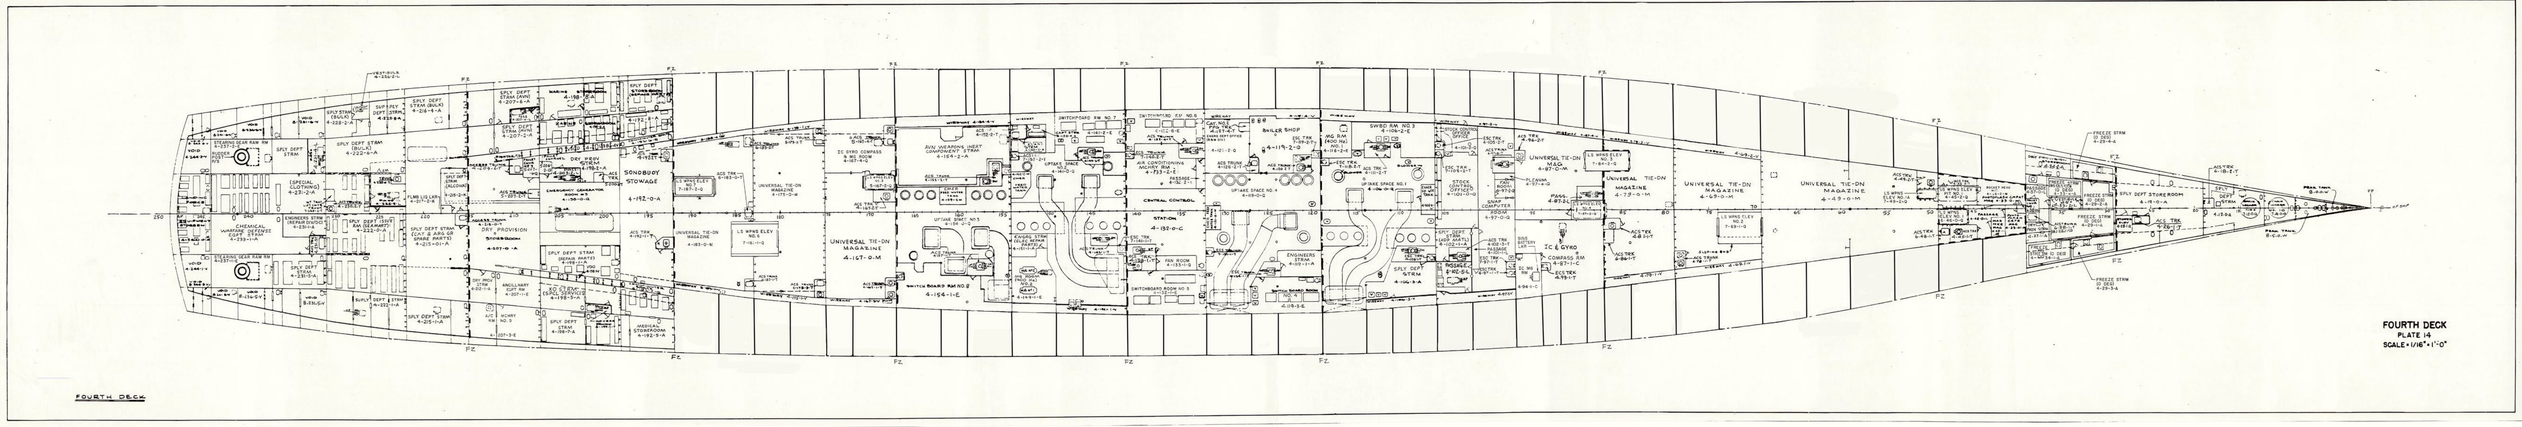
FOURTH DECK
PLATE 14
SCALE = 1/16" = 1'-0"
FOURTH DECK
SONOBUOY STOWAGE
4-192-0-A
UNIVERSAL TIE-ON MAGAZINE
4-167-0-M
BOILER SHOP
4-119-2-0
CENTRAL CONTROL
STAT-ON
4-132-0-C
UNIVERSAL TIE-ON MAGAZINE
4-87-0-M
UNIVERSAL TIE-ON MAGAZINE
4-73-0-M
UNIVERSAL TIE-ON MAGAZINE
4-49-0-M
SPLY DEPT STORE ROOM
4-18-0-A
IC & GYRO
COMPASS RM
4-127-1-C
SWBD RM NO 3
4-106-2-E
SWBD RM NO 2
4-154-1-E
SWITCHBOARD RM NO 2
SWITCHBOARD RM NO 3
SWITCHBOARD RM NO 6
SWITCHBOARD RM NO 7
ENGINEERS STORE
4-109-0-A
ENGINEERS STORE
4-109-1-A
SPLY DEPT STREM
4-106-1-A
SPLY DEPT STRM
4-125-1-A
MEDICAL STOREROOM
4-192-1-A
SPLY DEPT STRM
4-222-1-A
SPLY DEPT STRM
4-223-1-A
CHEMICAL WARFARE EQPT STORE
4-239-1-A
SPLY DEPT STRM
4-226-1-A
SPLY DEPT STRM
4-207-2-A
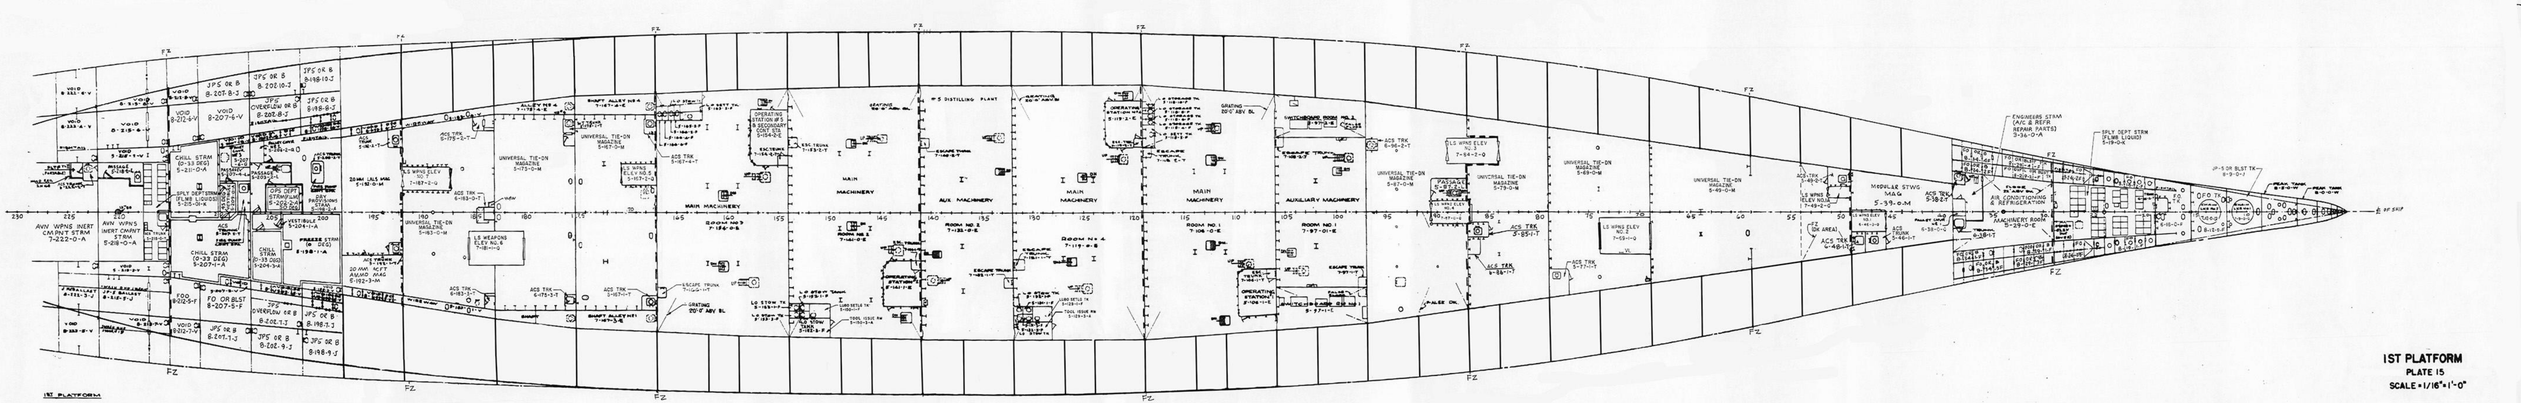

1ST PLATFORM

1ST PLATFORM

PLATE 15

SCALE = 1/16" = 1'-0"

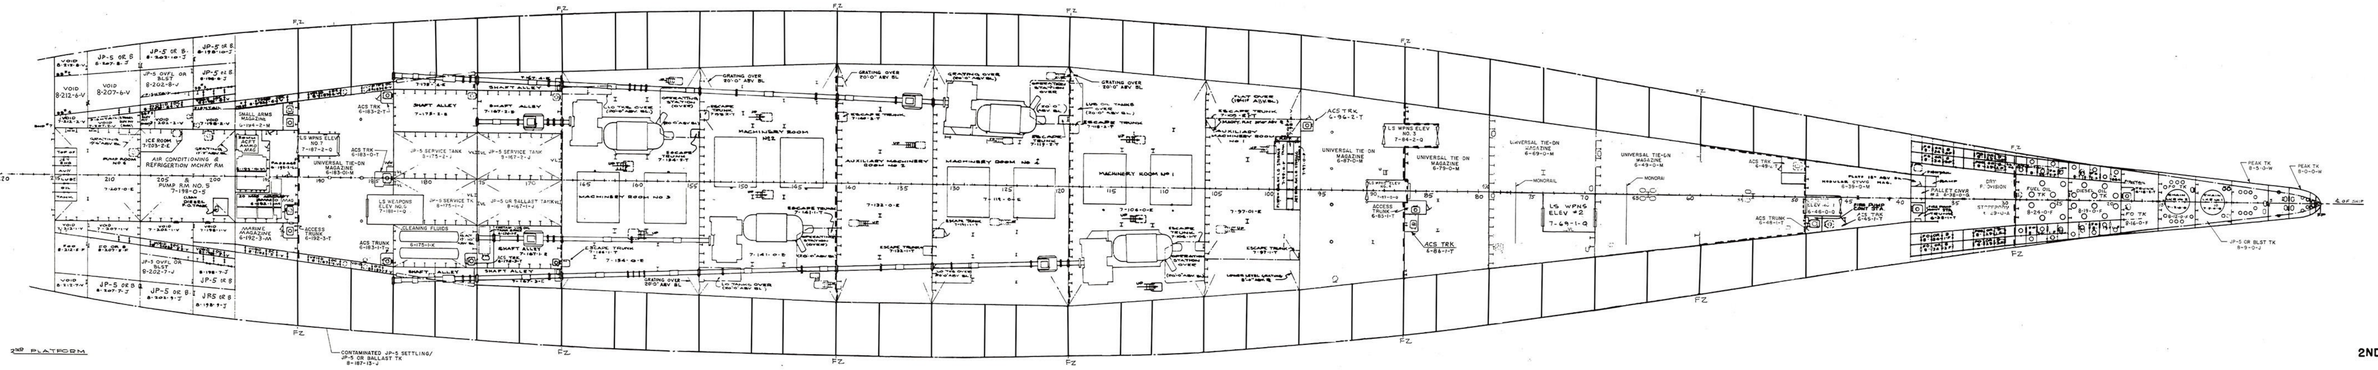

2ND PLATFORM

PLATE 16

SCALE = 1/16"=1'-0"

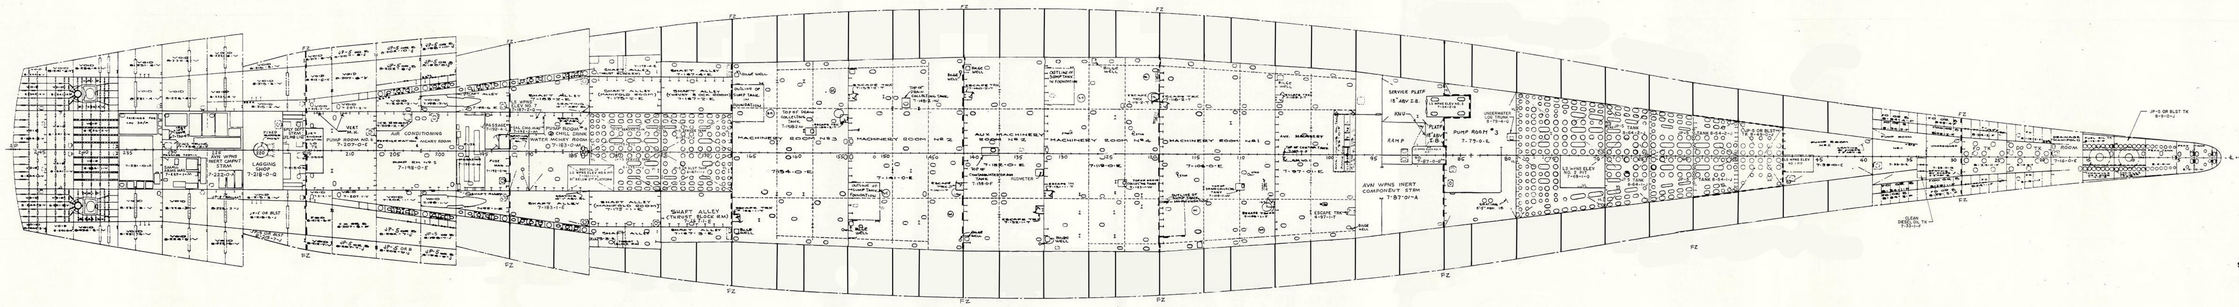
HOLD
SCALE 1/16" = 1 FOOT
CV-60 PLATE 17
HOLD
LAGGING SHOP
7-21-0-0
SHAFT ALLEY
(TRUNK BLOCK RM)
MACHINERY ROOM NO. 3
MACHINERY ROOM NO. 2
MACHINERY ROOM NO. 4
MACHINERY ROOM NO. 1
AUX MACHINERY ROOM NO. 2
AUX MACHINERY ROOM NO. 1
PUMP ROOM NO. 3
7-75-0-L
SERVICE PLATF
AVN WPNS INERT
COMPONENT STRM
7-87-0-A
AIR CONDITIONING
MACHINERY ROOM
7-154-0-E
7-118-0-E
7-119-0-E
7-87-0-E
7-87-0-F
7-207-0-E
7-192-0-E

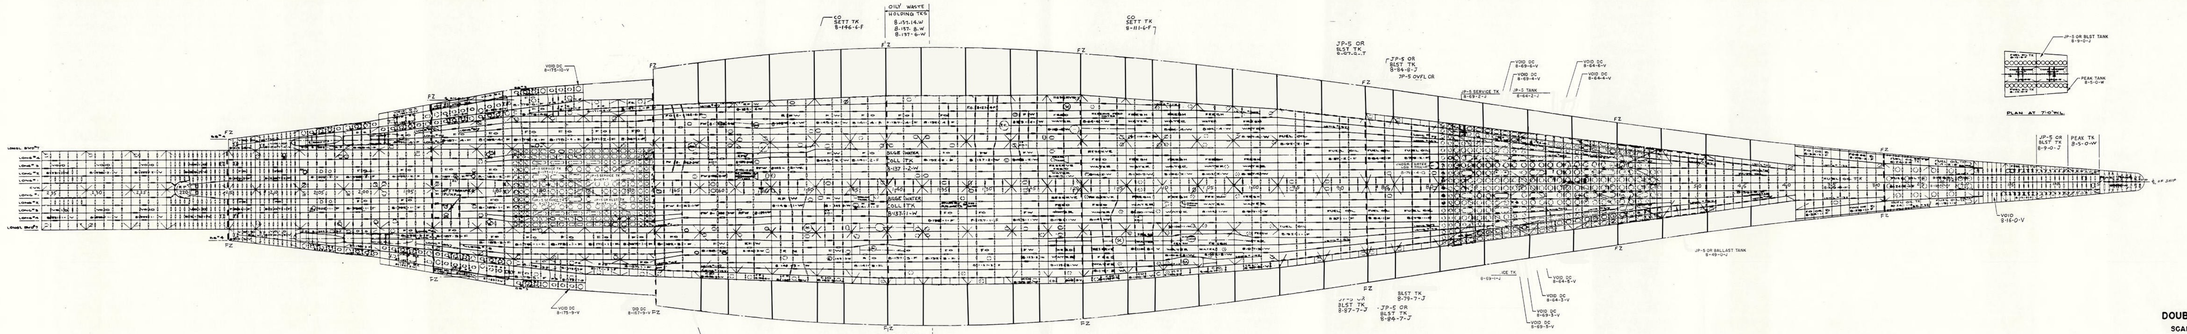

DOUBLE BOTTOM

SCALE 1/16" = 1 FOOT

CV-60 PLATE 18

07-SCR-001
25 JUN 2007

MEMORANDUM TO Thad White (PMS 333) X10639:

SUBJ: REDACTED SHIP DRAWINGS FOR THE USS SARATOGA AIRCRAFT CARRIER CV-6

Ref: (a) Durga Nanan e-mail, undated

Encl: (1) Shis Drawings for the Saratoga

I have reviewed the following sheets for the USS Saratoga Aircraft Carrier CV-6 and concur that the content of each sheet are suitable for public release:

Cover Sheet, Sheet No. 1, Plate No. 1
General Information Data, Sheet 1, Plate No. 2
Outboard profile-STBD, Sheet No. 2., Plate No 3
Outboard Profile-Port, Sheet No. 3, Plate No. 4
Inboard Profile, Sheet No. 7, Plate No. 5
Island Levels & Bridges, Sheet No. 3, Plate No. 6
Flight Deck, Sheet No. 4, Plate No. 7
Gallery Deck, Sheet No. 5, Plate No. 8
02 Level, Sheet No. 6, Plate No. 9
01 Level, Sheet No. 7, Plate No. 10
Main Deck, Sheet No. 8, Plate No. 11
Second Deck, Sheet No. 8, Plate No. 12,
Third Deck, Sheet No. 9, Plate No. 13
Fourth Deck, Sheet No. 9, Plate No. 14
First Platform, Sheet No. 10, Plate No. 15
Second Platform, Sheet No. 10, Plate No. 16
Hole, Sheet No. 11, Plate No. 17
Double Bottom, Sheet No. 11, Plate 18

Contact me at 781-2442 for any questions concerning the review of the drawings.

Toni M. Napper
(SEA 10P3)
NAVSEA Security Specialist